

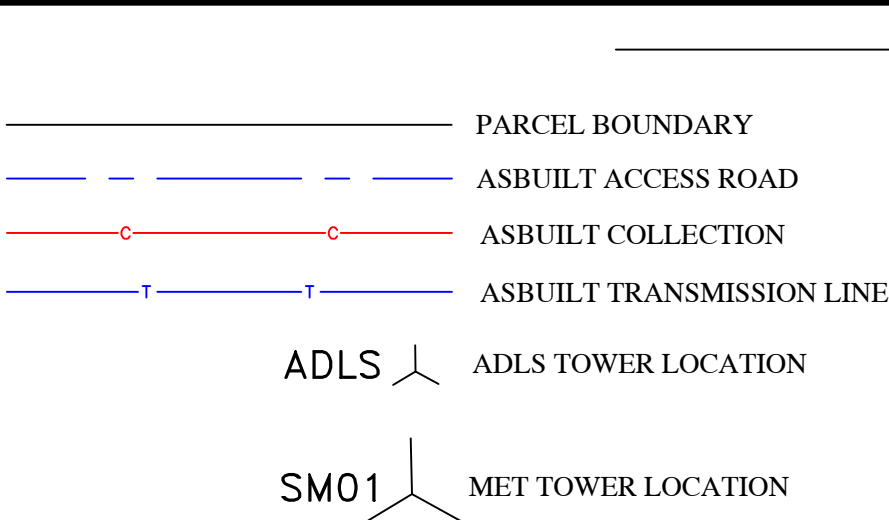


NOTE:
THIS SITE PLAN DOES NOT REPRESENT A SIGNED AND SEALED DOCUMENT. BOUNDARY LINES SHOWN WERE PROVIDED BY PUBLIC GIS DATA AND NOT TO BE RELIED UPON AS A LAND BOUNDARY SURVEY. ACTUAL BOUNDARY LINES AND EASEMENTS SHALL BE DETERMINED BY THE USER. IT IS THE RESPONSIBILITY OF THE USER TO DETERMINE IF THIS IS THE MOST RECENT SITE PLAN. WE DO NOT GUARANTEE THE ACCURACY OF INFORMATION PROVIDED BY OTHERS. THIS IS PROVIDED FOR PLANNING PURPOSES AND NOT TO BE RELIED UPON FOR ANY OTHER REASON.

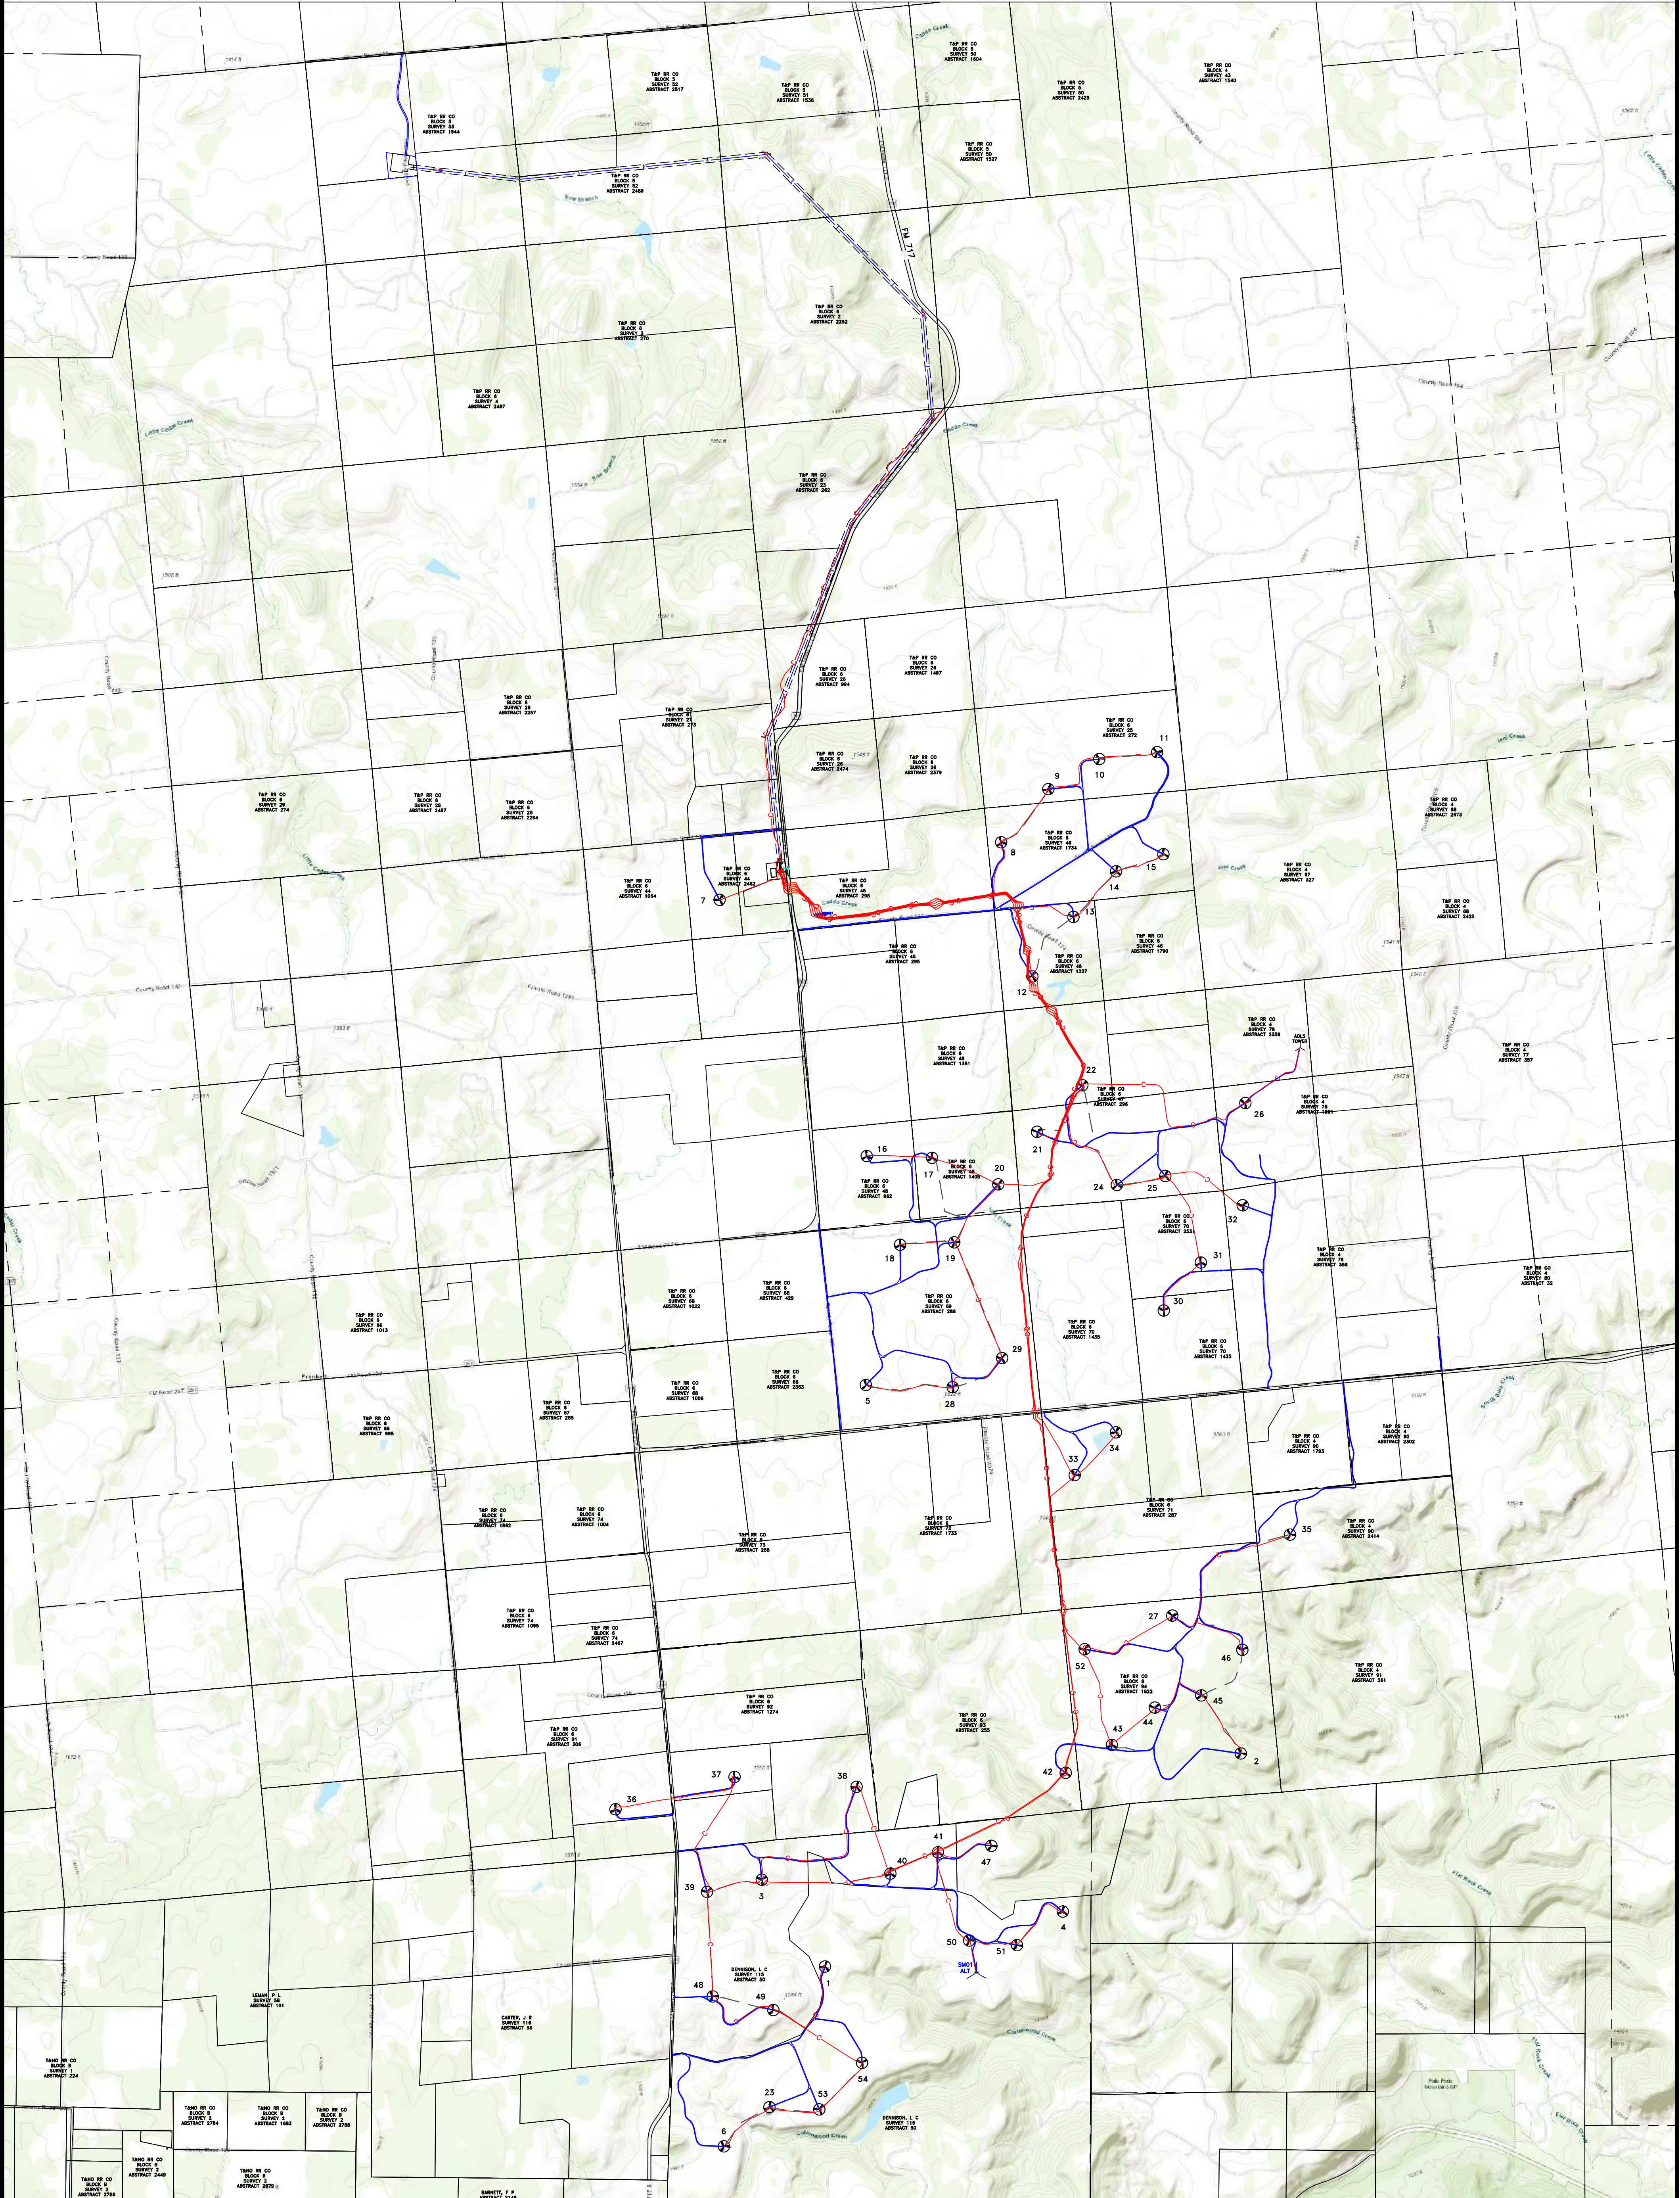

- XX  GE 2.82 MW 127 Meter Rotor Diameter
114 Meter Hub Height 10-03-24 Array
- XX  GE 2.52 MW 116 Meter Rotor Diameter
90 Meter Hub Height 10-03-24 Array
- XX  GE 2.82 MW 127 Meter Rotor Diameter
89 Meter Hub Height 10-03-24 Array
- XX  GE 2.72 MW 116 Meter Rotor Diameter
90 Meter Hub Height 10-03-24 Array

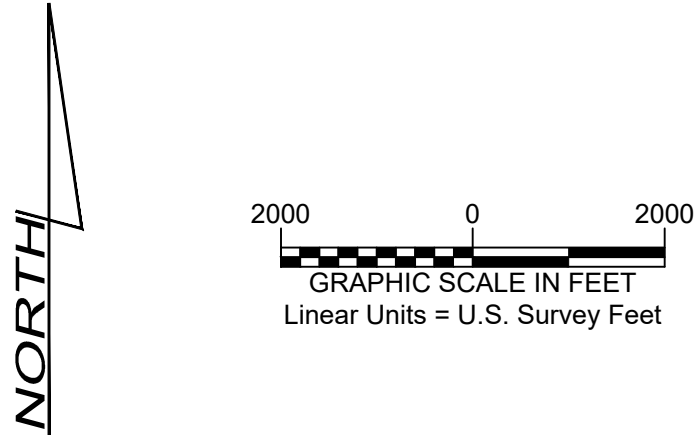

NEXTERA ENERGY RESOURCES
LA CASA WIND LLC
- ASBUILT SITE PLAN -
STEPHENS COUNTY, TEXAS

CookPLS National, Inc.
13800 Wireless Way
Oklahoma City, OK 73134
405-603-5511



Project: LA CASA WIND, LLC
Scale: See Graphic Scale
Date: 1/23/2026
Drafted: JGW
Checked: RJC
SITE PLAN OVERALL 24X36 (SHEET 1)
LA CASA WIND ASBUILT SITE PLAN.dwg

Revision/Date